

Customer	:	CU-DAR001 Dart Helicopters Services	Drawing Name	:	407 FWD X-TUBE
Job Number	:	43341			
Estimate Number	:	12348			
P.O. Number	:		Part Number	:	D407667105
This Issue	:	12/11/2008	S.O. No.	:	
Prsht Rev.	:	NC	Drawing Number	:	D407-667-145 REV B
First Issue	:	//	Project Number	:	N/A
Previous Run	:	43340	Drawing Revision	:	B
		Type	:	CROSSTUBES	
Written By	:		Material	:	
Checked & Approved By	:		Due Date	:	02/12/2008
Comment	:		Qty:		1 Um: Each
	:				

Drawing Number : D407-667-145 REV B
 Project Number : N/A
 Drawing Revision : B
 Material :
 Due Date : 02/12/2008

Qty: 1 Um: Each

A DSI 9415 Rev. A
 90.11.17

Est Rev: F 05.09.01 Add holes for compatibility with Bell

Comment	Rev	Date	Description
	Est Rev:F	05.09.01	Add holes for compatibility with Bell
	Skid tubes	KJ/JLM	
	Est Rev:G	08-05-16	chg QC6 to QC15 DD verified by:EC
	Est Rev:H	08-06-03	update as per DSI9415 (ECN1198) DD verified by:ec
	Est Rev:I	08-07-14	add (scribe inside of tube) seq.6 DD verified by:EC
	Est Rev:J	08-07-28	update as per (par 08-013) DD verified by:EC

Additional Product

Job Number:



Seq. #:	Machine Or Operation:	Description :
1	1000	1000
2	1000	1000
1.0 DC DOCUMENT CONTROL



Comment: DOCUMENT CONTROL

Photocopy bluefile and create labels as per PPP D407-667-105 CHG003 ✓

2.0	PACKAGING 1	PACKAGING RESOURCE #1
-----	-------------	-----------------------



Comment: PACKAGING RESOURCE #1

3.0	D407667105TRN	Crosstube Turning Detail
-----	---------------	--------------------------



Comment: Qty.: 1.0000 Each(s)/Unit/ Total: 1.0000 Each(s)

CROSSTUBE TURNING DETAIL

batch **b-4165**

4.0 BENDING BENDING MACHINE - SKIDTUBES





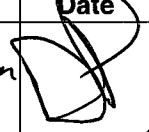

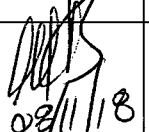
Comment: BENDING MACHINE

Bend tube as per Dwg D407-667-145 using CNC bender program 407-fw and Folio FT016

Page 1

W/O:		WORK ORDER CHANGES					
DATE	STEP	PROCEDURE CHANGE	By	Date	Qty	Approval Chief Eng / Prod Mgr	Approval QC Inspector

Part No: D407-667-105 PAR #: N/A Fault Category: Prod - x tube NCR: Yes No DQA: A Date: 08/11/20
 Resolution: Scrap Disposition: Scrap QA: N/C Closed: AJ Date: 08/11/20

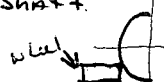NCR: 43341		WORK ORDER NON-CONFORMANCE (NCR)						
DATE	STEP	Description of NC Section A	Corrective Action Section B			Verification Section C	Approval Chief Eng	Approval QC Inspector
			Initial Chief Eng	Action Description Chief Eng	Sign & Date			
08-11-13	4.0	During bending, the encoder wheel fell down, resulting in the tangent line passing through the rollers, and over bending the tube. R.C. wheel was not properly positioned when tightened on the shaft. 	 08/11/18 PSI 42	Tube is scrap. Very uneven on the height. 2nd encoder wheel is to soon be received in, so not up or down adjustments will have to be made.	 8-11-18 08/11/20	 08/11/18 PSI 42	 08/11/13	

NOTE: Date & initial all entries

Date: Wednesday, 12/11/2008 1:31:25 PM
User: Julie Dawson

Process Sheet

Customer: CU-DAR001 Dart Helicopters Services

Drawing Name: 407 FWD X-TUBE

Job Number: 43341

Part Number: D407667105

Job Number:



Seq. #:	Machine Or Operation:	Description :
---------	-----------------------	---------------

5.0

QC15

DIMENSIONAL CHECK OF X-TUBES



Comment: DIMENSIONAL CHECK OF X-TUBES

6.0

CROSSTUBES

CROSSTUBES RESOURCE 1



Comment: LANDING GEAR RESOURCE 1

1- scribe batch # inside of cuff

2-Drill pilot holes in tube using drill Jig DT8541 & DT8542 as per Dwg D407-667-145. Drill all (3) top holes.

3-Drill and Ream all holes in tube to finish size using drill Jig DT8541 & DT8542 as per Dwg D407-667-145
Check dimensions between holes on all four sides.

4-Flip tube and switch drilling Jigs from right to left, left to right. Locate Jigs off existing holes using "T" pins.

5-Drill pilot holes using drill Jig DT8541 & DT8542 as per Dwg 407-667-145. Drill only the top (2) holes.

6-Drill & ream the top (2) holes to finish size using drill Jig DT8541 & DT8542 as per Dwg D407-667-145

7-Drill Fwd rivet holes using drill Jig DT8787FWD as per Dwg D206-667-145. Note: Fwd side has 3x top holes.

8-Drill Aft rivet holes using drill Jig DT8787AFT as per Dwg D407-667-145.

9-C'sink holes as per Dwg D407-667-145. Allow rivet to sit below surface to compensate for paint.

10 -Deburr & Inspect for surface damage. Repair damage within limits as per Dwg D407-667-145

7.0

HAND FINISHING1

HAND FINISHING RESOURCE #1



Comment: HAND FINISHING RESOURCE #1

Chemical Conversion Coat as per QSI 005 4.1

8.0

QC3

INSPECT POWDER COAT/CHEMICAL CONVERSION



Comment: INSPECT POWDER COAT/CHEMICAL CONVERSION

9.0

QC5

INSPECT WORK TO CURRENT STEP



Comment: INSPECT WORK TO CURRENT STEP

W/O:		WORK ORDER CHANGES					
DATE	STEP	PROCEDURE CHANGE	By	Date	Qty	Approval Chief Eng / Prod Mgr	Approval QC Inspector

Part No: _____ PAR #: _____ Fault Category: _____ NCR: Yes No DQA: _____ Date: _____

Resolution: _____ Disposition: _____ QA: N/C Closed: _____ Date: _____

NCR:		WORK ORDER NON-CONFORMANCE (NCR)						
DATE	STEP	Description of NC Section A	Corrective Action Section B			Verification Section C	Approval Chief Eng	Approval QC Inspector
			Initial Chief Eng	Action Description Chief Eng	Sign & Date			

NOTE: Date & initial all entries

Date: Wednesday, 12/11/2008 1:31:25 PM
User: Julie Dawson

Process Sheet

Customer: CU-DAR001 Dart Helicopters Services

Drawing Name: 407 FWD X-TUBE

Job Number: 43341

Part Number: D407667105

Job Number:



Seq. #:	Machine Or Operation:	Description :
---------	-----------------------	---------------

10.0	OUTSIDE SERV.11	OUTSIDE SERVICE -CROSSTUBES
------	-----------------	-----------------------------



Comment: Sub-Contracting OUTSIDE SERVICE -CROSSTUBES

11.0	PACKAGING 1	PACKAGING RESOURCE #1
------	-------------	-----------------------



Comment: PACKAGING RESOURCE #1

Inspect for transit damage

Ensure copy of NDT results attached to work order.

12.0	QC6	DIMENSIONAL CHECK
------	-----	-------------------



Comment: Inspect for damage & ensure results are as per Dwg D206-667-145

13.0	SPRAY PAINTING	SPRAY PAINTING
------	----------------	----------------



Comment: SPRAY PAINTING

1-Prime inside and outside crosstube as per QSI 005 4.2

2-Paint outside crosstube with White Imron as per QSI 005 4.2

14.0	QC14	INSPECT SPRAY PAINT
------	------	---------------------



Comment: Inspect Spray Paint

Wrap in plastic bag to protect from scratches

15.0	D3595075395	RUBBER CUSHION .75" x 3.95
------	-------------	----------------------------



Comment: Qty.: 4.0000 Each(s)/Unit Total : 4.0000 Each(s)

RUBBER CUSHION .75" x 3.95

batch: _____

16.0	D2873043	Nut Plate Assembly
------	----------	--------------------



Comment: Qty.: 2.0000 Each(s)/Unit Total : 2.0000 Each(s)

Pick:

Qty Part number Description Batch

2 D2873-043 Nut Plate _____

W/O:		WORK ORDER CHANGES					
DATE	STEP	PROCEDURE CHANGE	By	Date	Qty	Approval Chief Eng / Prod Mgr	Approval QC Inspector

Part No: _____ PAR #: _____ Fault Category: _____ NCR: Yes No DQA: _____ Date: _____

Resolution: _____ Disposition: _____ QA: N/C Closed: _____ Date: _____

NCR:		WORK ORDER NON-CONFORMANCE (NCR)						
DATE	STEP	Description of NC Section A	Corrective Action Section B			Verification Section C	Approval Chief Eng	Approval QC Inspector
			Initial Chief Eng	Action Description Chief Eng	Sign & Date			

NOTE: Date & initial all entries

Date: Wednesday, 12/11/2008 1:31:25 PM
User: Julie Dawson

Process Sheet

Customer: CU-DAR001 Dart Helicopters Services

Drawing Name: 407 FWD X-TUBE

Job Number: 43341

Part Number: D407667105

Job Number:



Seq. #:	Machine Or Operation:	Description :
---------	-----------------------	---------------

17.0	D2873045	Nut Plate Assembly
------	----------	--------------------



Comment: Qty.: 2.0000 Each(s)/Unit Total : 2.0000 Each(s)

Pick:

Qty Part number Description Batch

2 D2873-045 Nut Plate _____

18.0	D28911	2.25 Support
------	--------	--------------



Comment: Qty.: 2.0000 Each(s)/Unit Total : 2.0000 Each(s)

Pick:

Qty Part number Description Batch

2 D2891-1 Support _____

19.0	MS20601AD4W10	RIVET
------	---------------	-------



Comment: Qty.: 14.0000 Each(s)/Unit Total : 14.0000 Each(s)

Pick:

Qty Part number Description Batch

14 MS20601AD4W10 Rivet _____

20.0	MS2192020	Clamp (per MIL-DTL-8783C)
------	-----------	---------------------------



Comment: Qty.: 4.0000 Each(s)/Unit Total : 4.0000 Each(s)

Pick:

Qty Part number Description Batch

4 MS21920-20 Clamp _____

21.0	CROSSTUBES	CROSSTUBES RESOURCE 1
------	------------	-----------------------



Comment: LANDING GEAR RESOURCE 1

1-Install abrasion strips as per QSI 035 using DT8579. .Note: (2) top holes should be facing up.

2-Install supports and clamps as per Dwg D407--667-145. Torque clamps to 80-100 in lb

3-Install nut plates as per Dwg D407-667-145. Touch-up rivet heads with Imron paint.

W/O:		WORK ORDER CHANGES					
DATE	STEP	PROCEDURE CHANGE	By	Date	Qty	Approval Chief Eng / Prod Mgr	Approval QC Inspector

Part No: _____ PAR #: _____ Fault Category: _____ NCR: Yes No DQA: _____ Date: _____

Resolution: _____ Disposition: _____ QA: N/C Closed: _____ Date: _____

NCR:		WORK ORDER NON-CONFORMANCE (NCR)						
DATE	STEP	Description of NC Section A	Corrective Action Section B			Verification Section C	Approval Chief Eng	Approval QC Inspector
			Initial Chief Eng	Action Description Chief Eng	Sign & Date			

NOTE: Date & initial all entries

Date: Wednesday, 12/11/2008 1:31:26 PM
User: Julie Dawson

Process Sheet

Customer: CU-DAR001 Dart Helicopters Services

Drawing Name: 407 FWD X-TUBE

Job Number: 43341

Part Number: D407667105

Job Number:



Seq. #:	Machine Or Operation:	Description :
---------	-----------------------	---------------

22.0

QC5

INSPECT WORK TO CURRENT STEP



Comment: INSPECT WORK TO CURRENT STEP

23.0

PACKAGING 1

PACKAGING RESOURCE #1



Comment: PACKAGING RESOURCE #1

Pick Packing Kit

24.0

AN532A

Bolt



Comment: Qty.: 4.0000 Each(s)/Unit Total : 4.0000 Each(s)

Bolt

Batch: _____

25.0

MS21042L5

Nut



Comment: Qty.: 4.0000 Each(s)/Unit Total : 4.0000 Each(s)

Nut

Batch: _____

26.0

AN510A

Bolt



Comment: Qty.: 10.0000 Each(s)/Unit Total : 10.0000 Each(s)

Batch: _____

27.0

AN530A

BOLT



Comment: Qty.: 4.0000 Each(s)/Unit Total : 4.0000 Each(s)

Pick:Packing Kit

Qty Part number

Description Batch

4 AN5-30A

Bolt _____

28.0

AN960JD516

Washer



Comment: Qty.: 18.0000 Each(s)/Unit Total : 18.0000 Each(s)

Pick:Packing Kit

Qty Part number

Description Batch

18 AN960JD516

Washer _____

W/O:		WORK ORDER CHANGES					
DATE	STEP	PROCEDURE CHANGE	By	Date	Qty	Approval Chief Eng / Prod Mgr	Approval QC Inspector

Part No: _____ PAR #: _____ Fault Category: _____ NCR: Yes No DQA: _____ Date: _____

Resolution: _____ Disposition: _____ QA: N/C Closed: _____ Date: _____

NCR:		WORK ORDER NON-CONFORMANCE (NCR)						
DATE	STEP	Description of NC Section A	Corrective Action Section B			Verification Section C	Approval Chief Eng	Approval QC Inspector
			Initial Chief Eng	Action Description Chief Eng	Sign & Date			

NOTE: Date & initial all entries

Date: Wednesday, 12/11/2008 1:31:26 PM
User: Julie Dawson

Process Sheet

Customer: CU-DAR001 Dart Helicopters Services

Drawing Name: 407 FWD X-TUBE

Job Number: 43341

Part Number: D407667105

Job Number:



Seq. #:

Machine Or Operation:

Description :

29.0

QC4

INSPECT 100% KITS FOR COMPLETENESS



Comment: INSPECT 100% KITS FOR COMPLETENESS

30.0

PACKAGING 1

PACKAGING RESOURCE #1



Comment: PACKAGING RESOURCE #1

Identify and pack for shipping as per PPP D407-667-105

Location: _____

PPP Rev: _____

31.0

QC21

FINAL INSPECTION/W/O RELEASE



Comment: FINAL INSPECTION/W/O RELEASE

Job Completion



mf 08-11-18

W/O:		WORK ORDER CHANGES					
DATE	STEP	PROCEDURE CHANGE	By	Date	Qty	Approval Chief Eng / Prod Mgr	Approval QC Inspector

Part No: _____ PAR #: _____ Fault Category: _____ NCR: Yes No DQA: _____ Date: _____

Resolution: _____ Disposition: _____ QA: N/C Closed: _____ Date: _____

NCR:		WORK ORDER NON-CONFORMANCE (NCR)						
DATE	STEP	Description of NC Section A	Corrective Action Section B			Verification Section C	Approval Chief Eng	Approval QC Inspector
			Initial Chief Eng	Action Description Chief Eng	Sign & Date			

NOTE: Date & initial all entries

DART AEROSPACE LTD		Work Order: 43341
Description: Crosstube Assembly		Part Number: D407-667-145
Inspection Dwg: D407-667-145 Rev: B		Page 1 of 1

FIRST ARTICLE INSPECTION CHECKLIST

☒ First Article
 ☐ Prototype

Inspection Sheet	Drawing Dimension	Tolerance	Actual Dimension	Accept	Reject	Method of Inspection	Comments
SIDE A	2.240	+0.005/-0.000					
	1.865	+0.005/-0.000					
	1.878	+0.005/-0.000					
	1.970	+0.005/-0.000					
	2.030	+0.005/-0.000					
	2.165	+0.005/-0.000					
	0.125	+/-0.010					
	R0.063	+/-0.010					
	R0.500	+/-0.010					
	R0.063	+/-0.010					
	4.438	+/-0.010					
SIDE B	2.240	+0.005/-0.000					
	1.865	+0.005/-0.000					
	1.878	+0.005/-0.000					
	1.970	+0.005/-0.000					
	2.030	+0.005/-0.000					
	2.165	+0.005/-0.000					
	0.125	+/-0.010					
	R0.063	+/-0.010					
	R0.500	+/-0.010					
	R0.063	+/-0.010					
	4.438	+/-0.010					
	113.20	+/-0.020					

Measured by:		Audited by:		Prototype Approval:	N/A
Date:		Date:		Date:	N/A

Rev	Date	Change	Revised by	Approved
A	04.04.21	New Issue (P/O D407-667-105)	KJ/RF	
B	06.03.09	Dwg Rev updated	KJ/JLM	

W/O:		WORK ORDER CHANGES					
DATE	STEP	PROCEDURE CHANGE	By	Date	Qty	Approval Chief Eng / Prod Mgr	Approval QC Inspector

Part No: _____ PAR #: _____ Fault Category: _____ NCR: Yes No DQA: _____ Date: _____


Resolution: _____ Disposition: _____ QA: N/C Closed: _____ Date: _____

NCR:		WORK ORDER NON-CONFORMANCE (NCR)						
DATE	STEP	Description of NC Section A	Corrective Action Section B			Verification Section C	Approval Chief Eng	Approval QC Inspector
			Initial Chief Eng	Action Description Chief Eng	Sign & Date			

NOTE: Date & initial all entries

DART AEROSPACE LTD		Work Order: 43341
Description: Crosstube High Fwd (407)		Part Number: D407-667-105
Inspection Dwg: D407-667-145 Rev: B		Page 1 of 1

Required Dimension	Min	Max
Height	23.48	23.60
1/2 Span	45.88	46.0
Angle	54	56
Total Span	91.76	92.0

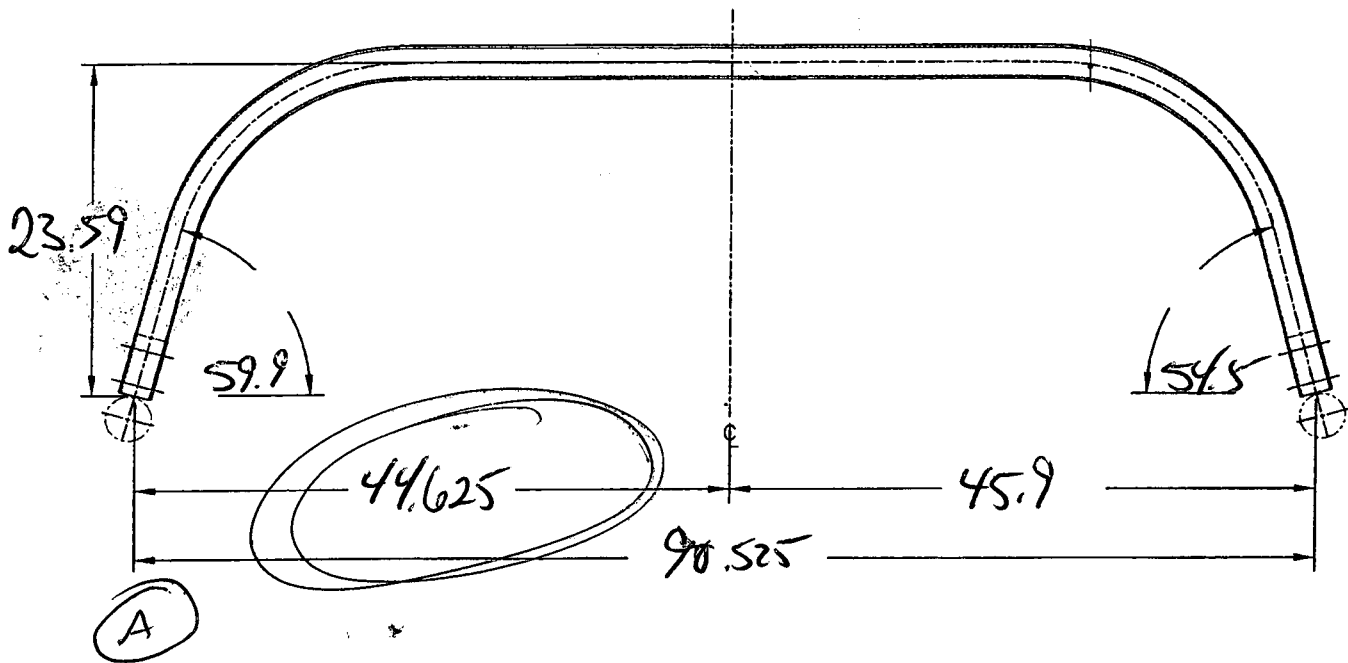

Comments
Tube is scrap 1 side over bent

QC15 Inspection	
Date	

Rev	Date	Change	Revised by	Approved
A	07.02.06	New Issue	KJ/JM	<i>[Signature]</i>

W/O:		WORK ORDER CHANGES					
DATE	STEP	PROCEDURE CHANGE	By	Date	Qty	Approval Chief Eng / Prod Mgr	Approval QC Inspector

Part No: _____ PAR #: _____ Fault Category: _____ NCR: Yes No DQA: _____ Date: _____

Resolution: _____ Disposition: _____ QA: N/C Closed: _____ Date: _____

NCR:		WORK ORDER NON-CONFORMANCE (NCR)						
DATE	STEP	Description of NC Section A	Corrective Action Section B			Verification Section C	Approval Chief Eng	Approval QC Inspector
			Initial Chief Eng	Action Description Chief Eng	Sign & Date			

NOTE: Date & initial all entries

DART

DESIGN PH	DRAWN BY PH	DART AEROSPACE LTD HAWKESBURY, ONTARIO, CANADA	
CHECKED PH DS	APPROVED PH DS	DRAWING NO. D407-667-145	REV. 8 SHEET 1 OF 3
DATE 05.07.26		TITLE CROSSTUBE ASS'Y (407 HIGH FWD) SCALE NTS	
A	02.05.08	NEW ISSUE	
B	05.07.26	ADD HOLES AND NUT PLATES FOR COMPATABILITY WITH BHT/AA SKIDTUBES	

RELEASED
05.07.26**UNDER REVIEW**
06.08.10
re-draw detail

Qty	Part Number	Description
X	D407-667-145	CROSSTUBE ASSEMBLY (407 HIGH FWD)
1	D6010-115	CROSSTUBE
2	D2856-400-694	ABRASION STRIP
2	D2873-043	NUT PLATE
2	D2873-045	NUT PLATE
2	D2891-1	SUPPORT
14	MS20601AD4W10	RIVET (OR NAS9302B-4-10)
4	MS21920-20	CLAMP
4	D3595-075-355	RUBBER CUSHION




OK CP
08.11.13**GENERAL NOTES:**

- 1) TOLERANCES ARE PER DART QSI 018 UNLESS OTHERWISE NOTED.
- 2) MATERIAL: MANUFACTURED FROM D6010-115
FINISHED LENGTH = 113.20 ± 0.020
- 3) FINISH: CHEMICAL CONVERSION COAT PER DART QSI 005 4.1
PRIME INSIDE AND OUTSIDE PER DART QSI 005 4.2
PAINT OUTSIDE PER DART QSI 005 4.2
- 4) PART IS SYMMETRIC ABOUT CENTERLINE.
- 5) RUN-OFF PART. BLEND OUT EDGE LONGITUDINALLY, TRANSITION SHOULD BE SMOOTH.
- 6) BEND PROGRESSIVELY WITH A MINIMUM OF 6 PASSES. MAXIMUM TUBE FLATTENING DUE TO BENDING IS 6% BASED ON O.D.
- 7) LIQUID PENETRANT INSPECT OUTSIDE SURFACE OF CROSSTUBE PER QSI 038.
- 8) SCRIBE DART PART NUMBER AND BATCH NUMBER IN THIS AREA WITH VIBRATING STYLUS.
- 9) INSTALL ~~D2856-400-694~~ ABRASION STRIP WITH A 0.13 (REF) GAP ON BOTTOM SIDE OF CROSSTUBE, CENTERED OPPOSITE ~~D2891-1~~ SUPPORT, PER QSI 035.
- 10) EXTREME CARE MUST BE TAKEN TO PROTECT THE OUTSIDE SURFACE OF THE TUBE. THE OUTSIDE SURFACE MUST BE SMOOTH AND FREE FROM SURFACE DEFECTS SUCH AS SCRATCHES, NICKS, OR DENTS. DEFECTS UP TO 0.005" MAY BE BLENDED OUT LONGITUDINALLY. CIRCUMFERENTIAL GRIND MARKS ARE UNACCEPTABLE.
- 11) SEAL EDGES OF SUPPORTS AND ABRASION STRIP USING SIKAFLEX-241/291 SEALANT (OPTIONAL).
- 12) TORQUE CLAMPS 80 TO 100 IN-LB.




SHOP COPY
RETURN TO
ENGINEERING
UNCONTROLLED COPY
SUBJECT TO AMENDMENT
WITHOUT NOTICE
WORK ORDER
NO. 43341

Copyright © 2002 by DART AEROSPACE LTD

THIS DOCUMENT IS PRIVATE AND CONFIDENTIAL AND IS SUPPLIED ON THE EXPRESS CONDITION THAT IT IS NOT TO BE USED FOR ANY PURPOSE OR COPIED OR COMMUNICATED TO ANY OTHER PERSON WITHOUT WRITTEN PERMISSION FROM DART AEROSPACE LTD.

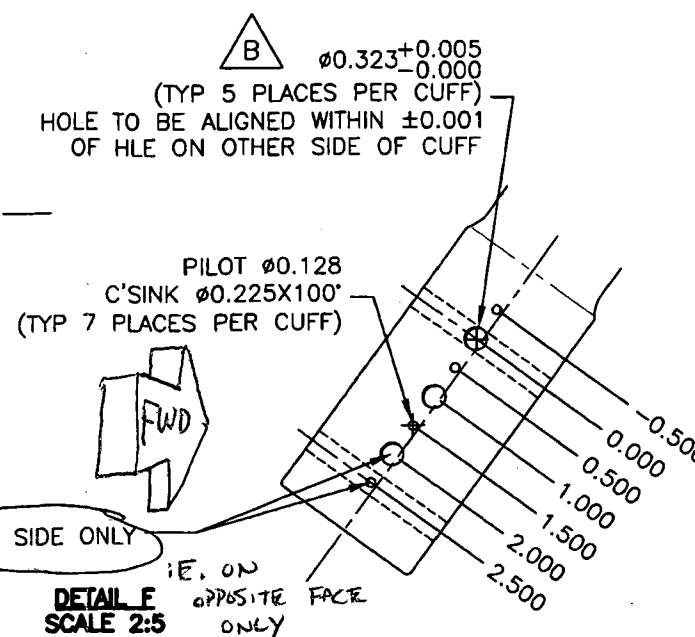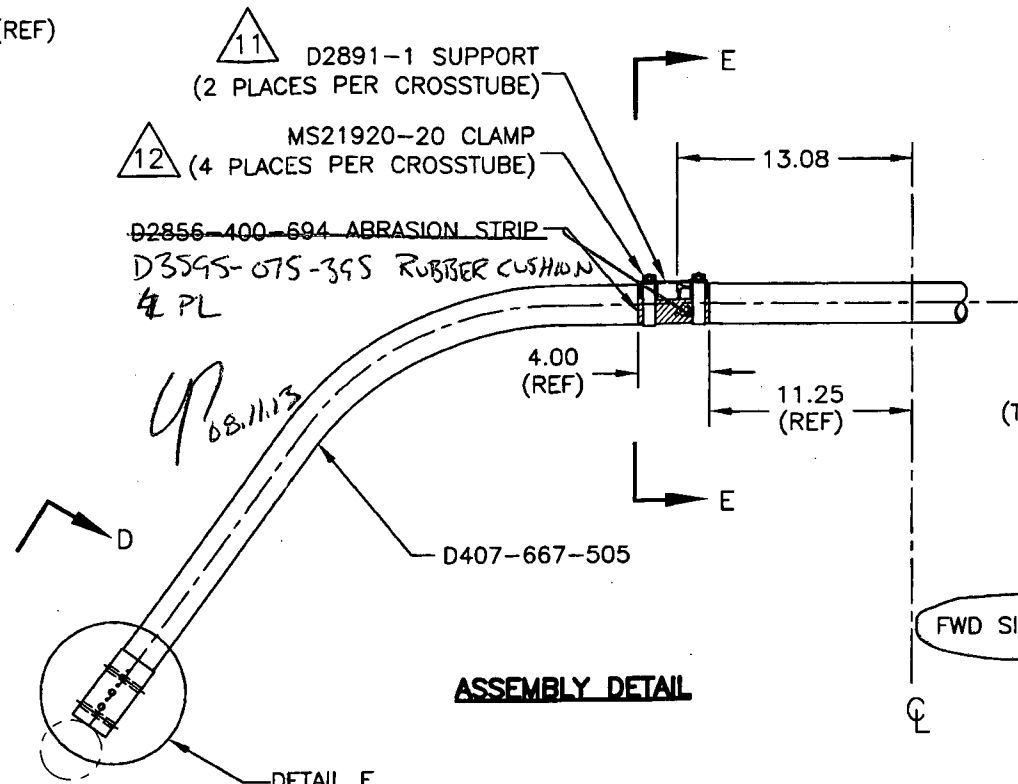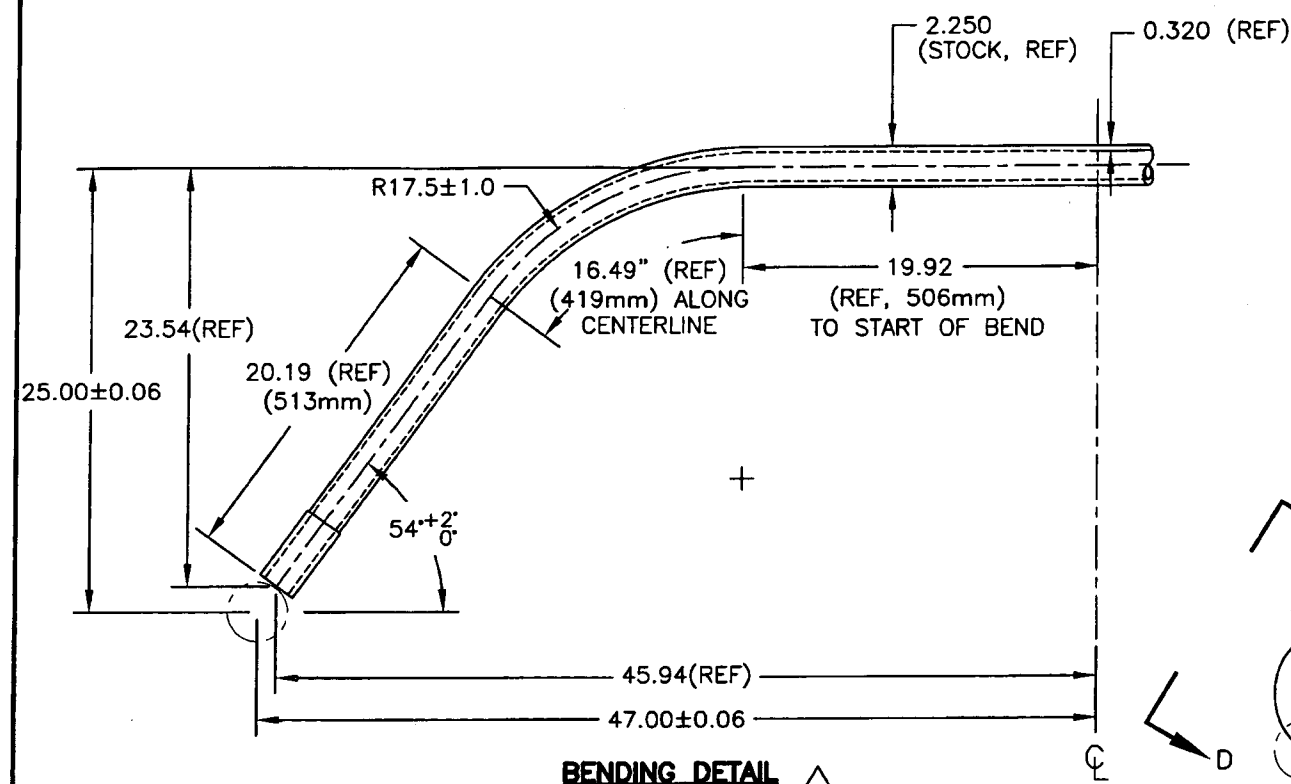


UNDER REVIEW
06-08-10 PH
re-draw detail F

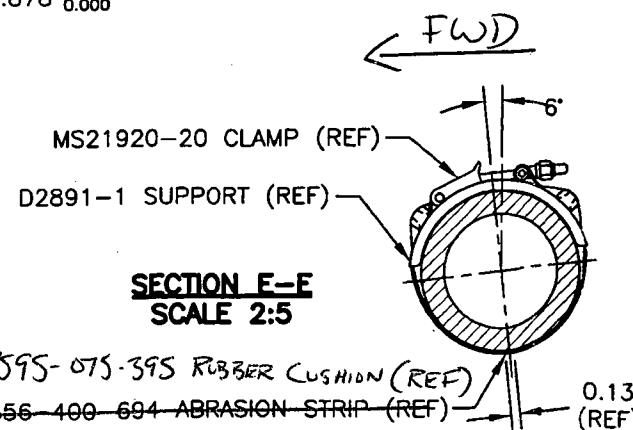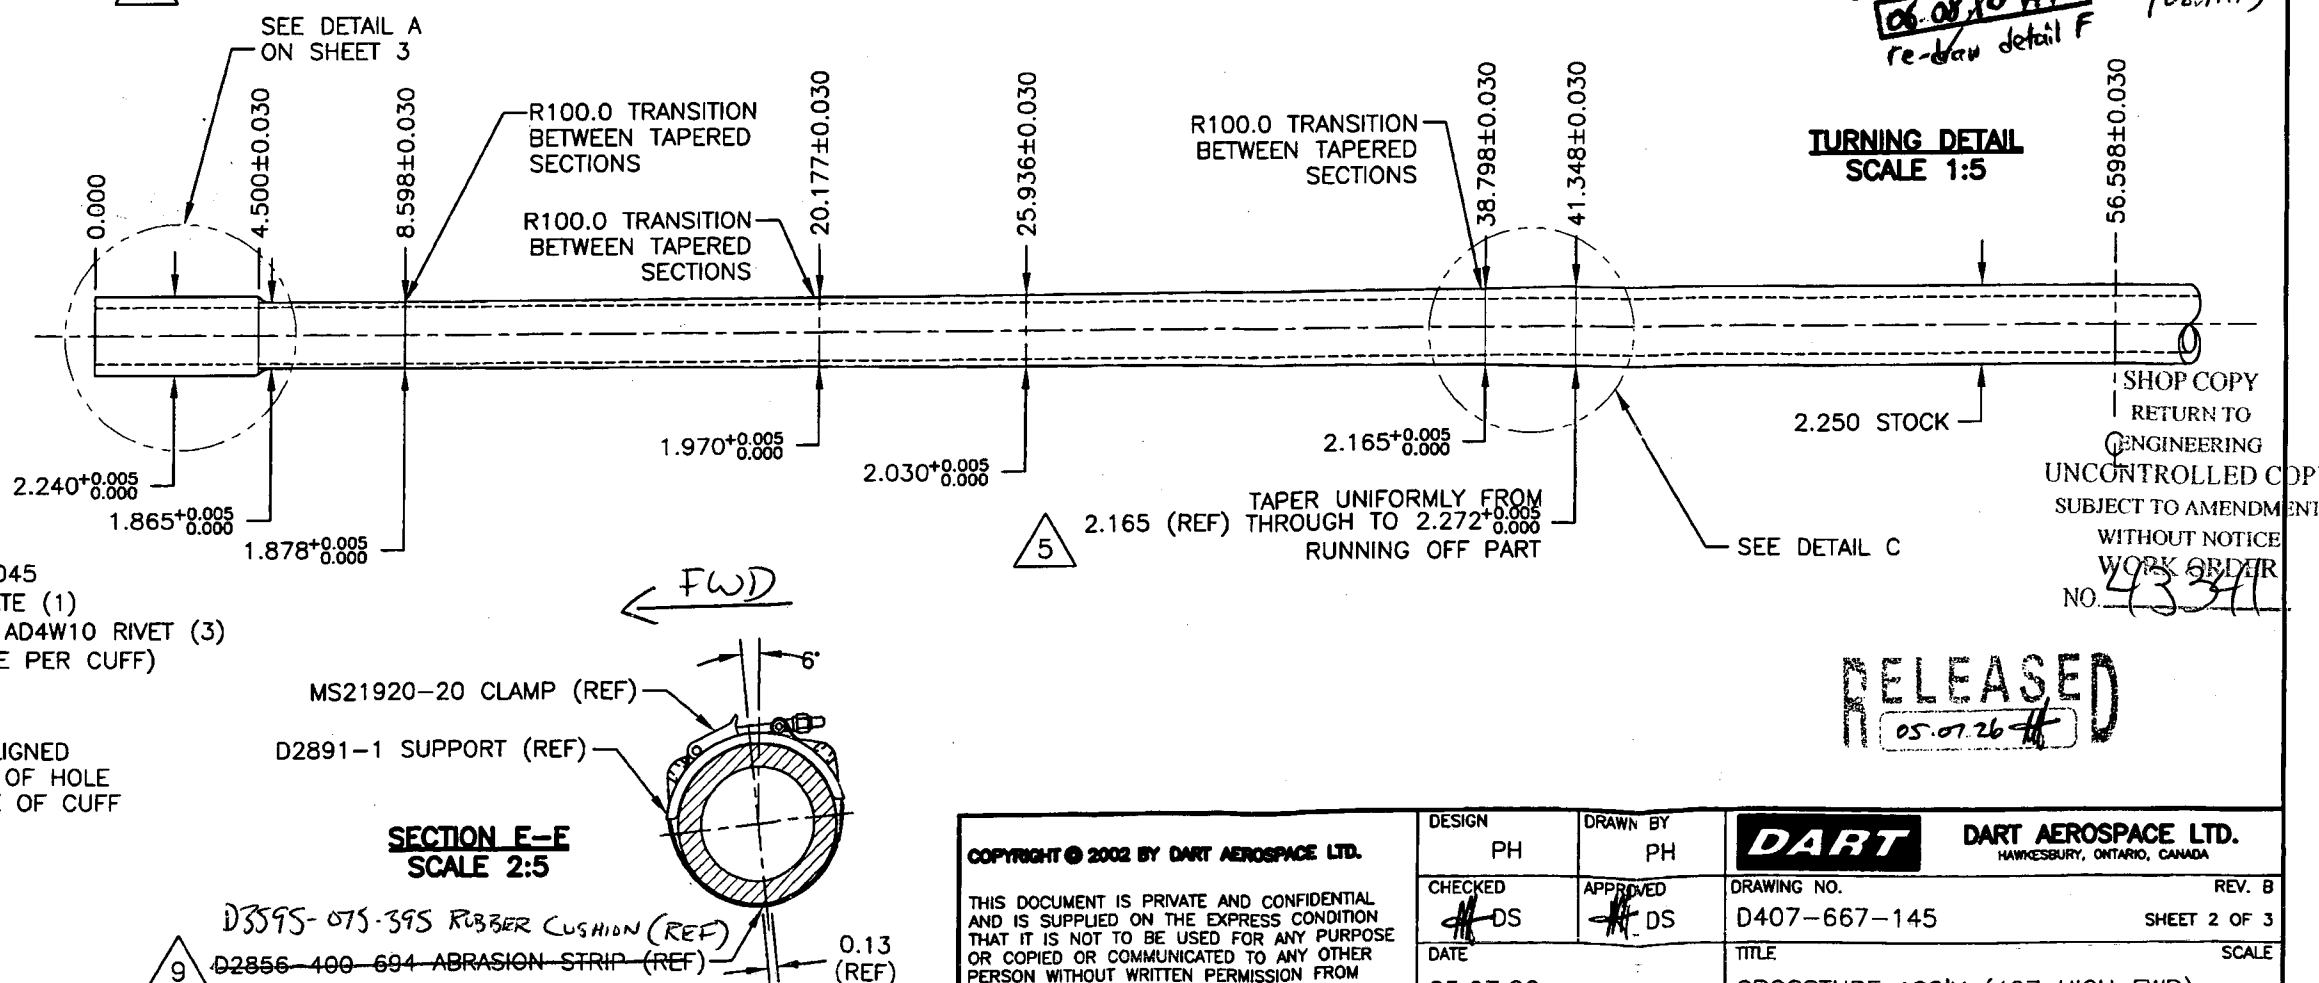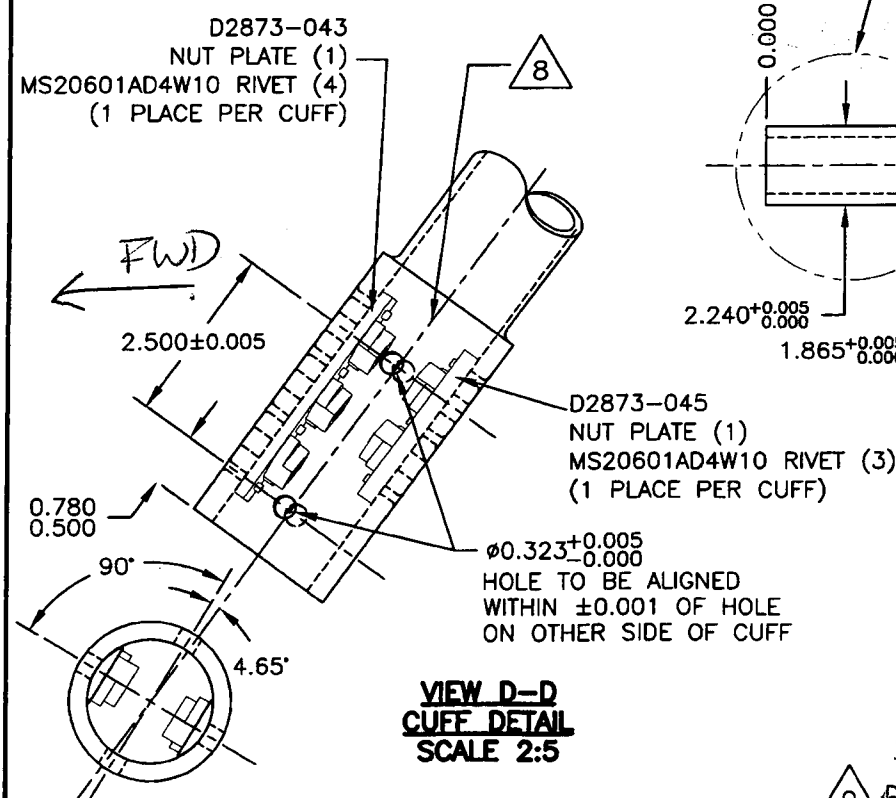

SHOP COPY
RETURN TO
ENGINEERING
UNCONTROLLED COPY
SUBJECT TO AMENDMENT
WITHOUT NOTICE
WORK ORDER
NO. 43341


RELEASED
05-07-26

COPYRIGHT © 2002 BY DART AEROSPACE LTD.		DESIGN PH	DRAWN BY PH	DART	DART AEROSPACE LTD. HAWKESBURY, ONTARIO, CANADA
THIS DOCUMENT IS PRIVATE AND CONFIDENTIAL AND IS SUPPLIED ON THE EXPRESS CONDITION THAT IT IS NOT TO BE USED FOR ANY PURPOSE OR COPIED OR COMMUNICATED TO ANY OTHER PERSON WITHOUT WRITTEN PERMISSION FROM DART AEROSPACE LTD.		CHECKED DS	APPROVED DS	DRAWING NO. D407-667-145	REV. B SHEET 2 OF 3
DATE 05.07.26		TITLE CROSSTUBE ASS'Y (407 HIGH FWD)		SCALE 1:10	

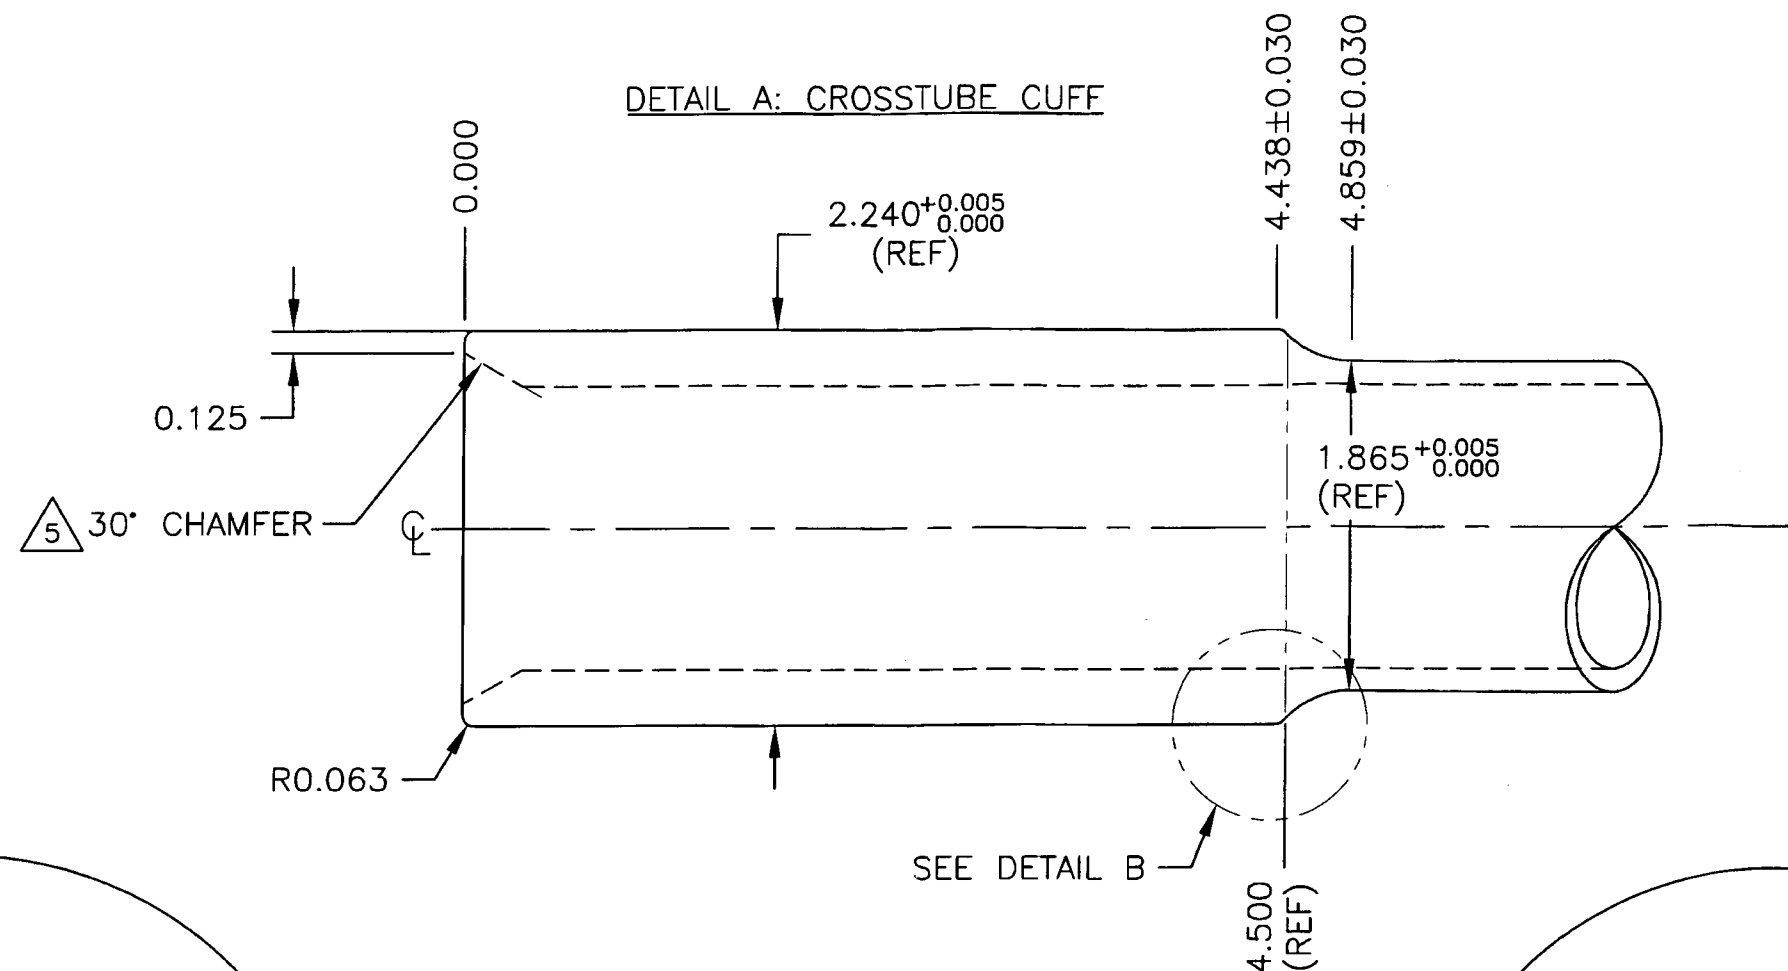


08.11.13
 UNDER REVIEW
 06.08.10 AY
 re-draw detail F

RELEASED
 05.07.26

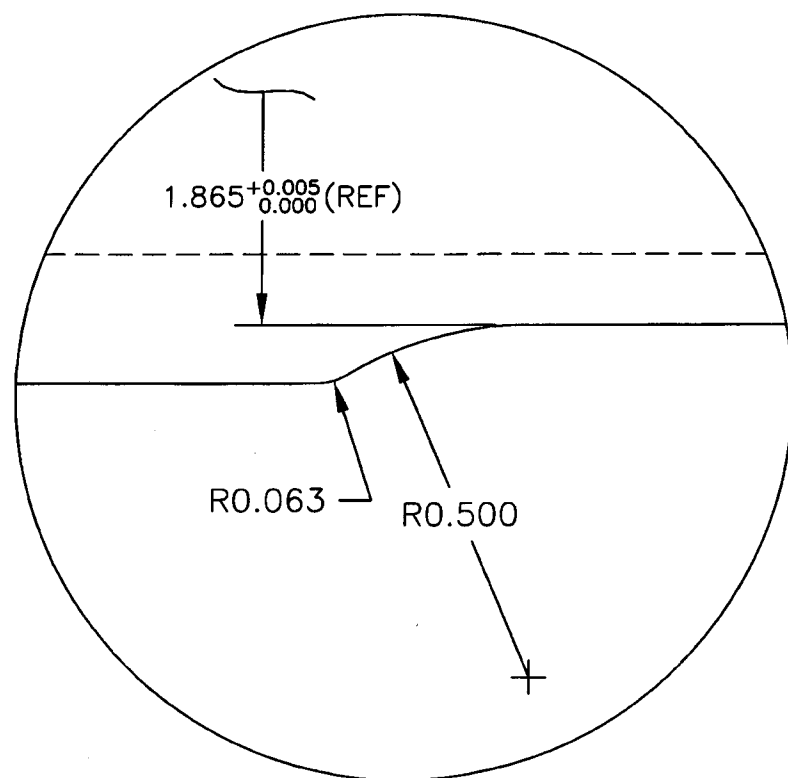

DETAIL C:
 TAPER RUN-OFF
 NOT TO SCALE

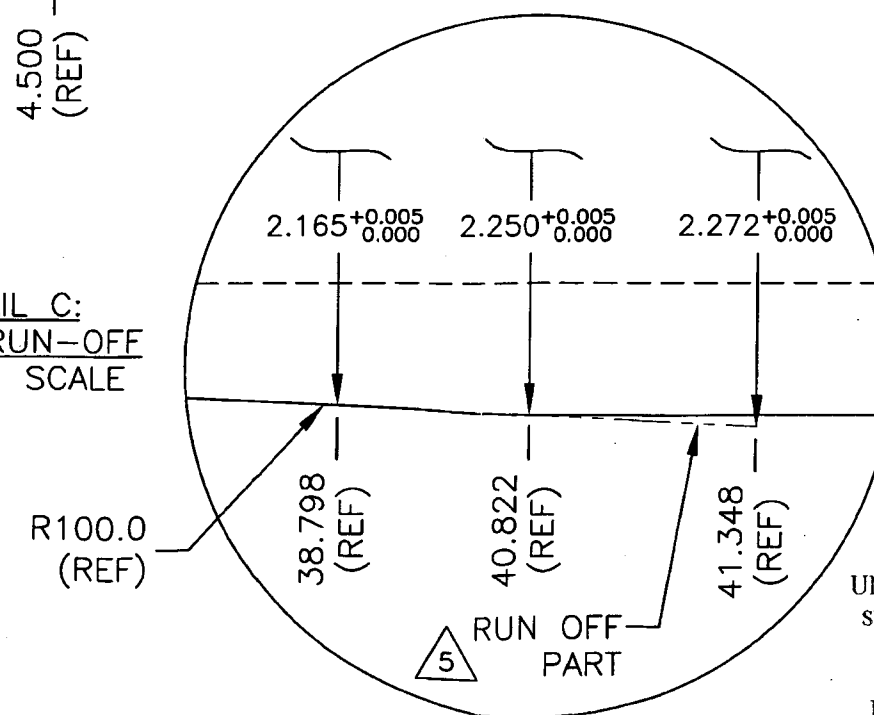

SHOP COPY
 RETURN TO
 ENGINEERING
 UNCONTROLLED COPY
 SUBJECT TO AMENDMENT
 WITHOUT NOTICE
 WORK ORDER
 NO. 43341

COPYRIGHT © 2002 BY DART AEROSPACE LTD.

THIS DOCUMENT IS PRIVATE AND CONFIDENTIAL
 AND IS SUPPLIED ON THE EXPRESS CONDITION
 THAT IT IS NOT TO BE USED FOR ANY PURPOSE
 OR COPIED OR COMMUNICATED TO ANY OTHER
 PERSON WITHOUT WRITTEN PERMISSION FROM
 DART AEROSPACE LTD.

DESIGN PH	DRAWN BY PH	DART	DART AEROSPACE LTD. HAWKESBURY, ONTARIO, CANADA
CHECKED DS	APPROVED DS	DRAWING NO. D407-667-145	REV. B SHEET 3 OF 3
DATE 05.07.26	TITLE CROSSTUBE ASS'Y (407 HIGH FWD)	SCALE 1:1	

SHOP COPY

RETURN TO

ENGINEERING

UNCONTROLLED COPY

SUBJECT TO AMENDMENT

WITHOUT NOTICE

WORK ORDER

NO. 43341

DART SERVICE INSTRUCTION

TO AMEND INSTALLATION INSTRUCTIONS IIN-D206-667 REV. C AND
INSTRUCTIONS FOR CONTINUED AIRWORTHINESS ICA-D206-667 REV. 2
REF: CANADIAN STC: SH01-5
REF: FAA STC: SR01304NY

For D206-667-101/-201/-103/-203 or D407-667-105 cross tubes at CHG 003 or later, the D2856-400-694/-773 abrasion strip has been removed, the center D2891-1 or D2892-1 support has been bonded onto the crosstube using Magnabond 6398 and D3595-075-395/-450 Rubber Cushions have been installed underneath the MS21920-20/-22 Clamps. Amend parts list of the IIN-D206-667 section 5 and ICA-D206-667 Section 32.8 as follows:

REMOVE:

ITEM	QTY -101	QTY -201	QTY -103	QTY -203	QTY -105	PART NUMBER	DESCRIPTION
13	2	2	2		2	D2856-400-694	ABRASION STRIP
14				2		D2856-400-773	ABRASION STRIP

ADD:

ITEM	QTY -101	QTY -201	QTY -103	QTY -203	QTY -105	PART NUMBER	DESCRIPTION
24	4	4	4		4	D3595-075-395	RUBBER CUSHION
25				4		D3595-075-450	RUBBER CUSHION

To prevent the supports from shifting on the D206-667-101/-201/-103/-203 or D407-667-105 crosstubes at CHG 002 or earlier, the D2891-1/D2892-1 supports should be removed and re-installed as follows:

- Follow section 32.1 of ICA-D206-667 for the removal of the crosstubes from the helicopter.
- Remove the qty (2) MS21920-20/-22 clamps from the crosstube that fasten the D2891-1/D2892-1 supports to the crosstube.
- Remove the D2856-400-694/-773 abrasion strip from the crosstube per section 32.5 of ICA-D206-667.
- Inspect the crosstube surface underneath the support for corrosion and mechanical damage per items 5.3.1 and 5.3.2 of the 300 hour inspection of ICA-D206-667. Repair damage within acceptable limits per item 5.3.3 of the 300 hour inspection in ICA-D206-667. Touch up finish per item 5.3.9 of the 300 hour inspection.
- Abrade area to which support will be applied with 400 grit sandpaper. Saturate a clean cloth with MEK or 4105S Wash'n'Wipe Degreaser or equivalent and wipe area until there is no residue.
- Apply a 0.03" to 0.06" thick layer of Magnabond 6398 underneath the D2891-1/D2892-1 support and re-install the support on the crosstube as shown in Figure 1. Position and secure the D2891-1/D2892-1 support on the crosstube using MS21920-20/-22 Clamps. Install a D3595-075-395/-450 Rubber cushion underneath each MS21920-20/-22 Clamp. Torque clamps 80-100 in-lb. Let the D206-667-101/-201/-103/-203 or D412-667-105 crosstube assembly cure as per the Magnabond 6398 instructions before re-installing the crosstube on the aircraft.

CANADA
DEPARTMENT OF TRANSPORT
AIRCRAFT CERTIFICATION
BRANCH
DAO # 01-O-01

APPROVED

BY: *[Signature]*
D. SHEPHERD (DE # 02)

DATE: 08.05.26
CERT. NO.: SH01-5
ISSUE NO.: 3

A	NEW ISSUE	HS	08.05.26
REV.	DESCRIPTION	BY	DATE
DESIGN	HS	DART AEROSPACE LTD HAWKESBURY, ONTARIO, CANADA	
DRAWN	HS		
CHECKED	<i>PH</i>	DRAWING NO.	REV. A
MFG. APPR.	<i>[Signature]</i>	DSI 9415	SHEET 1 OF 2
APPROVED	<i>[Signature]</i>	TITLE	SCALE
DE APPR.	<i>[Signature]</i>	CROSSTUBE SUPPORT CHANGE : NTS	
DATE	08.05.26	<small>COPYRIGHT © 2008 BY DART AEROSPACE LTD THIS DOCUMENT IS PRIVATE AND CONFIDENTIAL AND IS SUPPLIED ON THE EXPRESS CONDITION THAT IT IS NOT TO BE USED FOR ANY PURPOSE OR COPIED OR COMMUNICATED TO ANY OTHER PERSON WITHOUT WRITTEN PERMISSION FROM DART AEROSPACE LTD.</small>	

7) Re-install the D206-667-101/-201/-103/-203 or D412-667-105 crosstube per section 32.2 of ICA-D206-667.

For customers who would like to upgrade their D206-667-101/-201/-103/-203 or D412-667-105 crosstubes from CHG 002 or earlier to CHG 003, the following kit can be obtained from Dart:

QTY -011	QTY -013	PART NUMBER	DESCRIPTION
X		DSI 9415-011	CROSSTUBE SUPPORT CHANGE (USABLE ON D206-667-101/-201/-103 OR D407-667-105)
	X	DSI 9415-013	CROSSTUBE SUPPORT CHANGE (USABLE ON D206-667-203)
4		D3595-075-395	RUBBER CUSHION
	4	D3595-075-450	RUBBER CUSHION

CROSSTUBE
D206-667-101
D206-667-201
D206-667-103
D206-667-203
D407-667-105
REF

D2891-1 OR D2892-1
SUPPORT

CROSSTUBE
D206-667-101
D206-667-201
D206-667-103
D206-667-203
D407-667-105
REF

MS21920-20/-22
CLAMP

MAGNABOND 6398 BETWEEN D2891-1/D2892-1
SUPPORT AND CROSSTUBE

D3595-075-395/-450 RUBBER CUSHION
(REF) (2 PLACES)

SECTION A-A

PART NUMBER	DISTANCE "X"
D206-667-101	13.08"
D206-667-201	13.08"
D206-667-103	13.08"
D206-667-203	10.03"
D407-667-105	13.08"

SHOP COPY
RETURN TO
ENGINEERING
UNCONTROLLED COPY
SUBJECT TO AMENDMENT
WITHOUT NOTICE
WORK ORDER
NO. 43341

FIGURE 1 - CROSSTUBE SUPPORT

CANADA
DEPARTMENT OF TRANSPORT
AIRCRAFT CERTIFICATION
BRANCH
DAO # 01-O-01

APPROVED

BY: *D. Shepherd*
D. SHEPHERD (DE # 02)

DATE: 08.05.26
CERT. NO.: SH01-5
ISSUE NO.: 3

DESIGN	HS	DART AEROSPACE LTD	
DRAWN	HS	HAWKESBURY, ONTARIO, CANADA	
CHECKED	PH	DRAWING NO.	REV. A
MFG. APPR.	<i>[Signature]</i>	DSI 9415	SHEET 2 OF 2
APPROVED	<i>[Signature]</i>	TITLE	SCALE
DE APPR.	<i>[Signature]</i>	CROSSTUBE SUPPORT CHANGE	NTS
DATE	08.05.26	COPYRIGHT © 2008 BY DART AEROSPACE LTD THIS DOCUMENT IS PRIVATE AND CONFIDENTIAL AND IS SUPPLIED ON THE EXPRESS CONDITION THAT IT IS NOT TO BE USED FOR ANY PURPOSE OR COPIED OR COMMUNICATED TO ANY OTHER PERSON WITHOUT WRITTEN PERMISSION FROM DART AEROSPACE LTD.	